


**SOUTH ELEVATION**  
APPROX. 1:50



**WEST ELEVATION**  
APPROX. 1:50

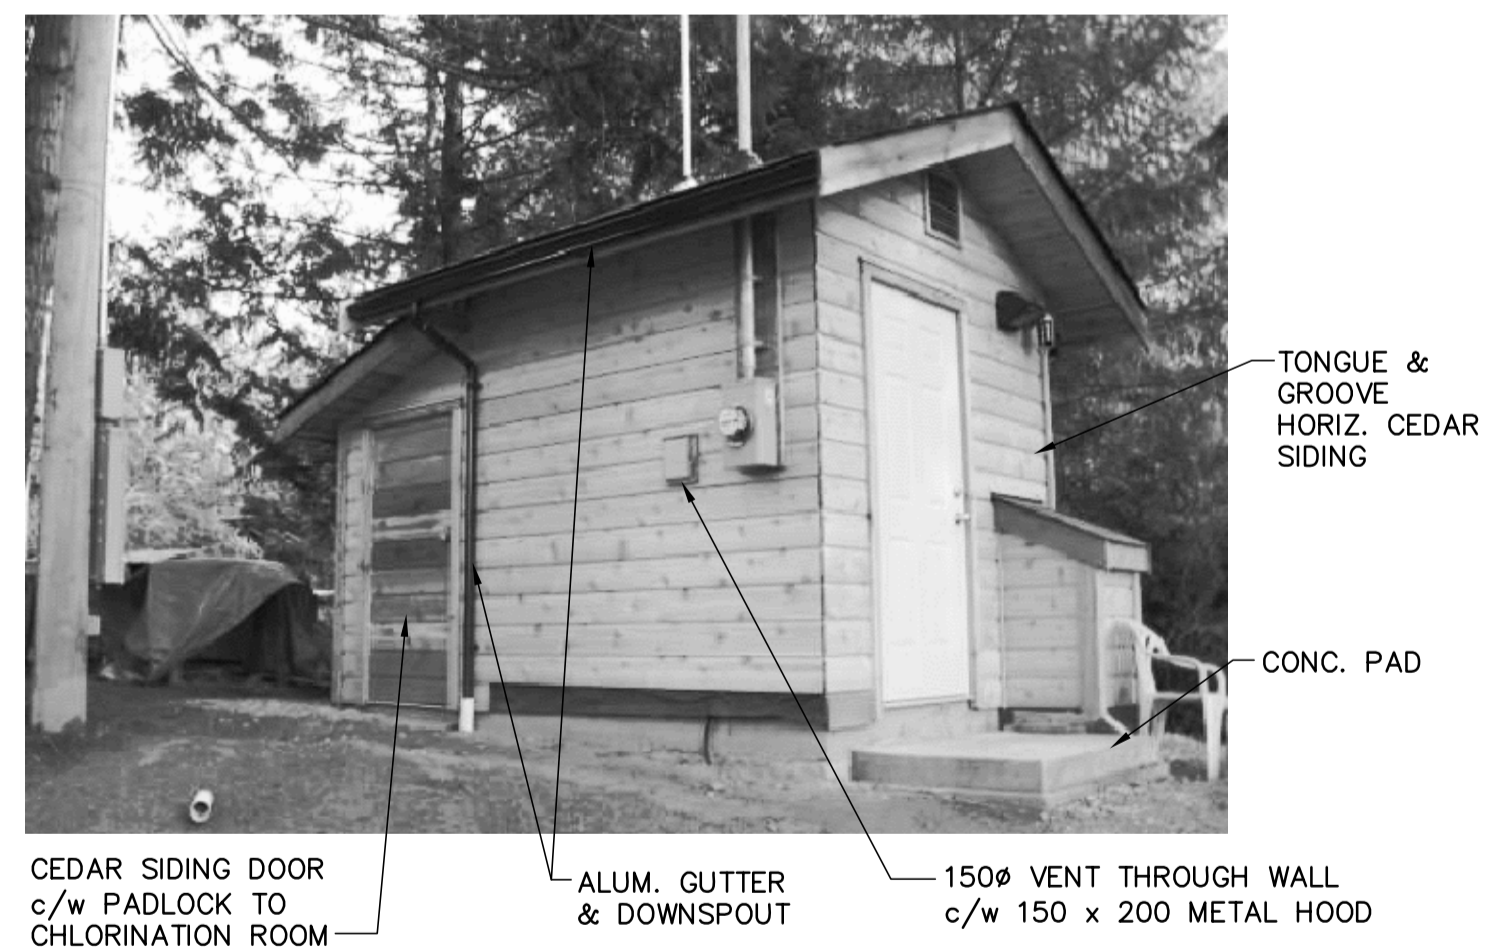

**NORTH ELEVATION**  
APPROX. 1:50

SEAL	BY	DATE	No.	REVISION	ENG.	No.	DATE	ISSUE
						1	05/05/09	AS CONSTRUCTED - RECORD DRAWING



Capital Regional District   Environmental Services		<b>CEDAR LANE WATER SYSTEM</b>	
DESIGNED	R.H.E.	SURVEYED	
DRAWN	L.N./M.M.	DATE	20/03/09
SCALE HORIZONTAL	AS SHOWN	CHECKED	R.H.E.
SCALE VERTICAL	AS SHOWN	APPROVED	D.T.
CONTRACT NUMBER		DRAWING NUMBER	26-D206-1
ISSUE	1	OF	2